
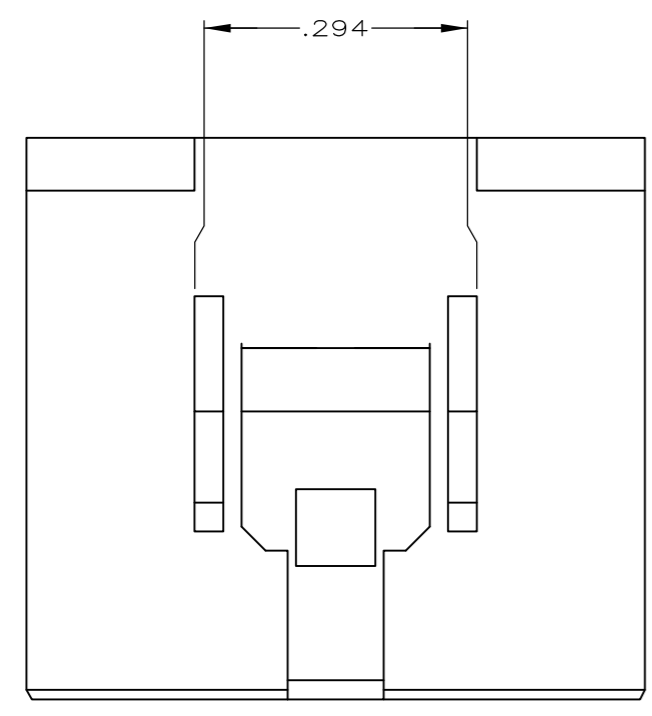
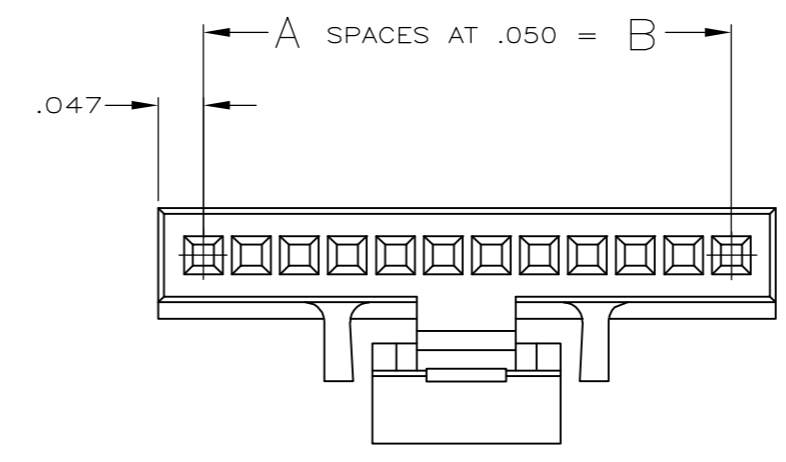
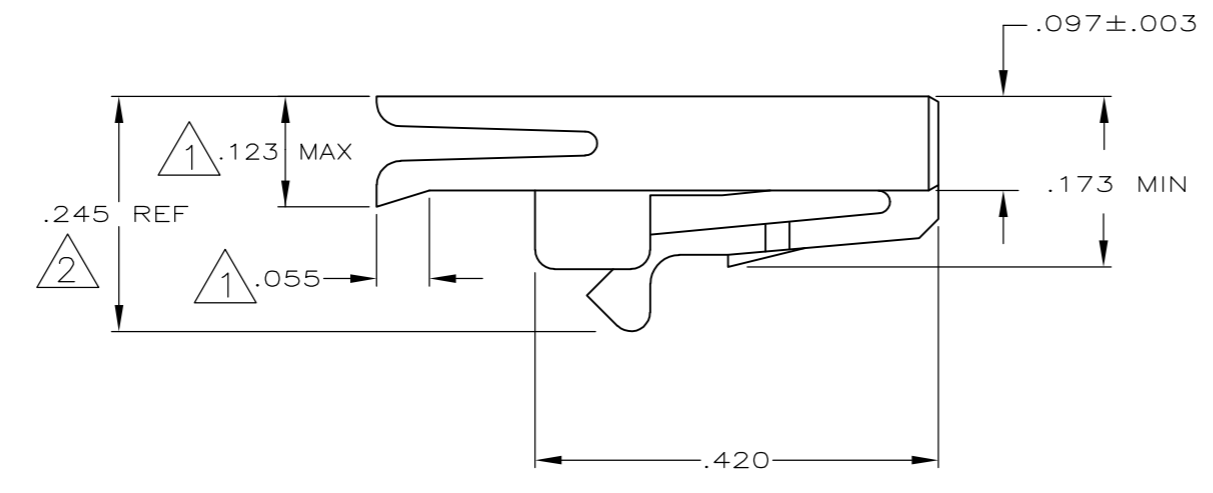
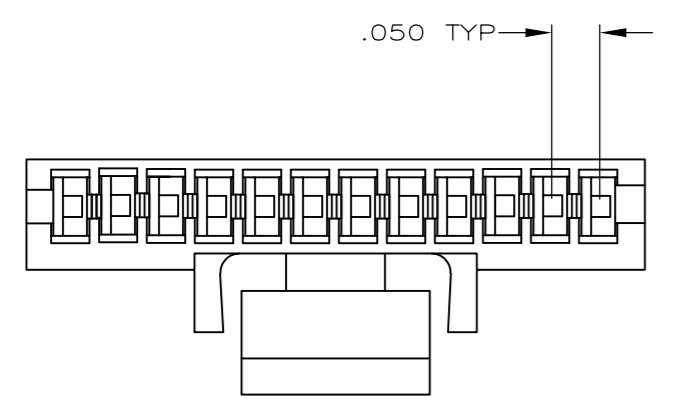
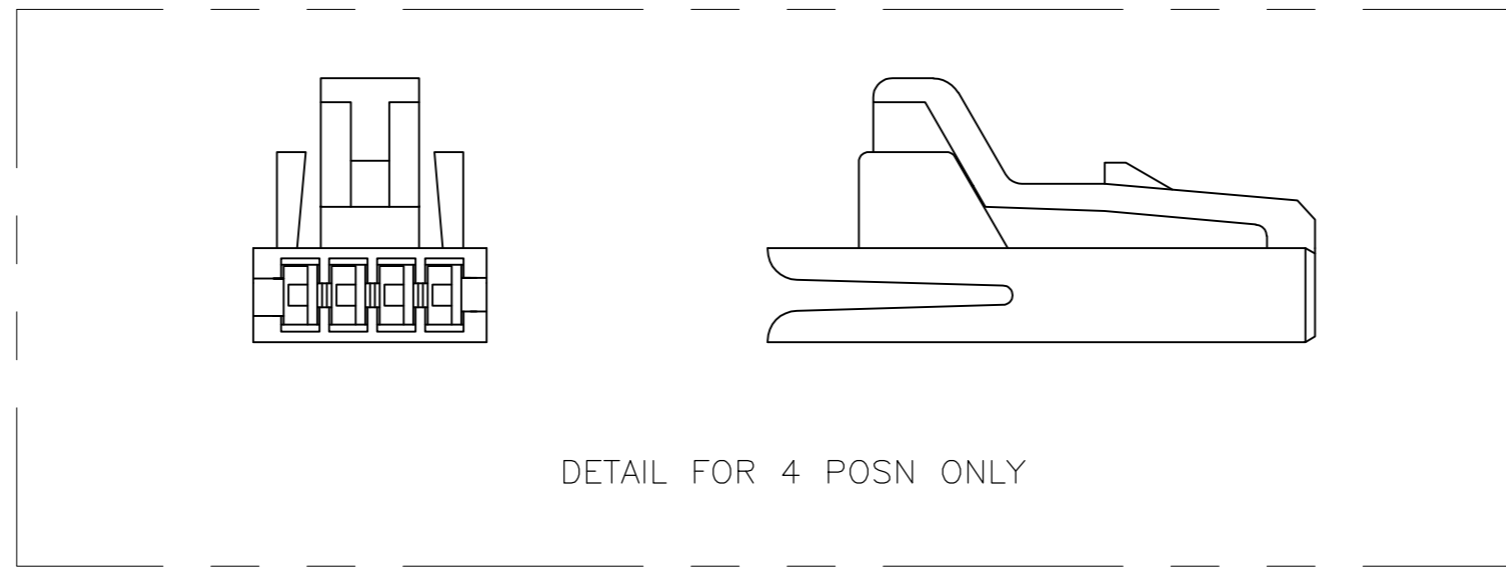


THIS DRAWING IS UNPUBLISHED. RELEASED FOR PUBLICATION  
 © COPYRIGHT - By - ALL RIGHTS RESERVED.

| LOC | DIST | REVISIONS |     |                           |           |     |      |
|-----|------|-----------|-----|---------------------------|-----------|-----|------|
| GP  | 00   | P         | LTR | DESCRIPTION               | DATE      | DWN | APVD |
|     |      | R         |     | REVISED PER ECO-11-017188 | 06DEC2011 | CJV | CWR  |

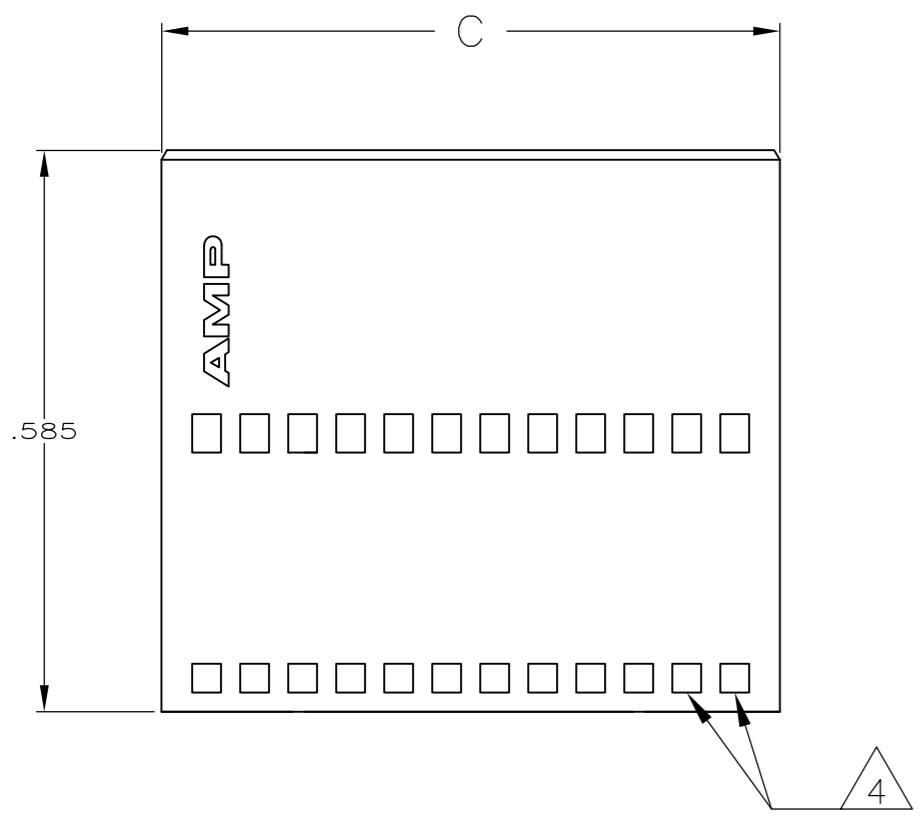

|                  |                  |               |               |                       |
|------------------|------------------|---------------|---------------|-----------------------|
| 2.543            | 2.450            | 49            | 50            | 4-487545-7            |
| 2.293            | 2.200            | 44            | 45            | 4-487545-2            |
| 2.043            | 1.950            | 39            | 40            | 3-487545-7            |
| 1.843            | 1.750            | 35            | 36            | 3-487545-3            |
| 1.543            | 1.450            | 29            | 30            | 2-487545-7            |
| <del>1.443</del> | <del>1.350</del> | <del>27</del> | <del>28</del> | <del>2-487545-5</del> |
| <del>1.343</del> | <del>1.250</del> | <del>25</del> | <del>26</del> | <del>2-487545-3</del> |
| 1.293            | 1.200            | 24            | 25            | 2-487545-2            |
| 1.143            | 1.050            | 21            | 22            | 1-487545-9            |
| 1.043            | .950             | 19            | 20            | 1-487545-7            |
| .893             | .800             | 16            | 17            | 1-487545-4            |
| .793             | .700             | 14            | 15            | 1-487545-2            |
| .693             | .600             | 12            | 13            | 1-487545-0            |
| .643             | .550             | 11            | 12            | 487545-9              |
| .543             | .450             | 9             | 10            | 487545-7              |
| .443             | .350             | 7             | 8             | 487545-5              |
| .393             | .300             | 6             | 7             | 487545-4              |
| .343             | .250             | 5             | 6             | 487545-3              |
| .293             | .200             | 4             | 5             | 487545-2              |
| .243             | .150             | 3             | 4             | 487545-1              |
| C                | B                | A             | POSN          | PART NO.              |

- 1 LIP DOES NOT APPLY TO 4 & 5 POSITION HOUSINGS.
- 2 THIS DIMENSION IS .275 REF. ON 4 POSITION HOUSING ONLY.
- 3 OBSOLETE PARTS: OBSOLETE CIS STREAMLINING PER D.RENAUD/D.SINISI.
- 4 WINDOWS MAY OR MAY NOT BE PRESENT ON THIS END OF THE HOUSING.

|  |   |--|---|-------------------------------|--|--------------------|-------|---|---|-------|---|---|-------|---|------|-------|---|---|--------|---|---|--------|---|---|-------------------|------------|--------------------|
| THIS DRAWING IS A CONTROLLED DOCUMENT.   |   | DWN<br>B. HAYMAKER<br>24MAY99 | TE Connectivity                          |                    |       | DIMENSIONS:<br>INCHES  |   | CHK<br>S. BOLASH<br>24MAY99   |  |                    | TOLERANCES UNLESS OTHERWISE SPECIFIED:   |   | APVD<br>S. BOLASH<br>24MAY99  | NAME<br>HOUSING, RECEPTACLE,<br>.050 C/L |                    |       | <table border="1"> <tr><td>0 PLC</td><td>±</td><td>-</td></tr> <tr><td>1 PLC</td><td>±</td><td>-</td></tr> <tr><td>2 PLC</td><td>±</td><td>-</td></tr> <tr><td>3 PLC</td><td>±</td><td>.005</td></tr> <tr><td>4 PLC</td><td>±</td><td>-</td></tr> <tr><td>ANGLES</td><td>±</td><td>-</td></tr> <tr><td>FINISH</td><td>-</td><td>-</td></tr> </table> |   | 0 PLC                         | ±  | -                  | 1 PLC | ± | - | 2 PLC | ± | - | 3 PLC | ± | .005 | 4 PLC | ± | - | ANGLES | ± | - | FINISH | - | - | PRODUCT SPEC<br>- | SIZE<br>A2 | CAGE CODE<br>00779 |
| 0 PLC  | ± | -                             |  |                    | 1 PLC  | ± | -                             |  |                    | 2 PLC  | ± | -                             |  |                    | 3 PLC  | ± | .005                          |  |                    | 4 PLC  | ± | -                             |  |                    | ANGLES   | ± | -                             |  |                    | FINISH   | - | -                             |  |                    | MATERIAL<br>POLYESTER, BLACK   |   | APPLICATION SPEC<br>-         | DRAWING NO<br>C=487545                   | RESTRICTED TO<br>- |       |   |  |   | WEIGHT<br>-                   | SCALE<br>5:1                             | SHEET<br>1 of 1    |       |   |  |   | CUSTOMER DRAWING              | REV<br>R                                 |                    |       
# Mouser Electronics

Authorized Distributor

Click to View Pricing, Inventory, Delivery & Lifecycle Information:

[TE Connectivity:](#)

[3-487545-3](#)