
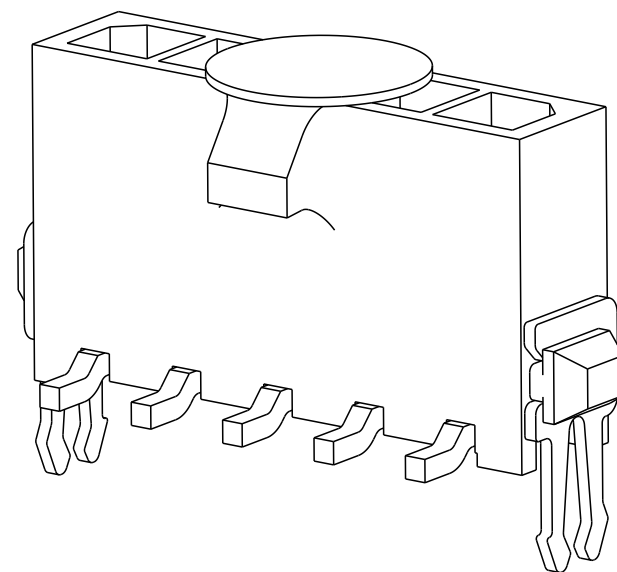


| REVISIONS |     |                           |           |     |      |
|-----------|-----|---------------------------|-----------|-----|------|
| P         | LTR | DESCRIPTION               | DATE      | DWN | APVD |
|           | CI  | REVISED PER ECR-16-011506 | 23JUN2017 | NK  | CX   |
|           |     |                           |           |     |      |
|           |     |                           |           |     |      |
|           |     |                           |           |     |      |

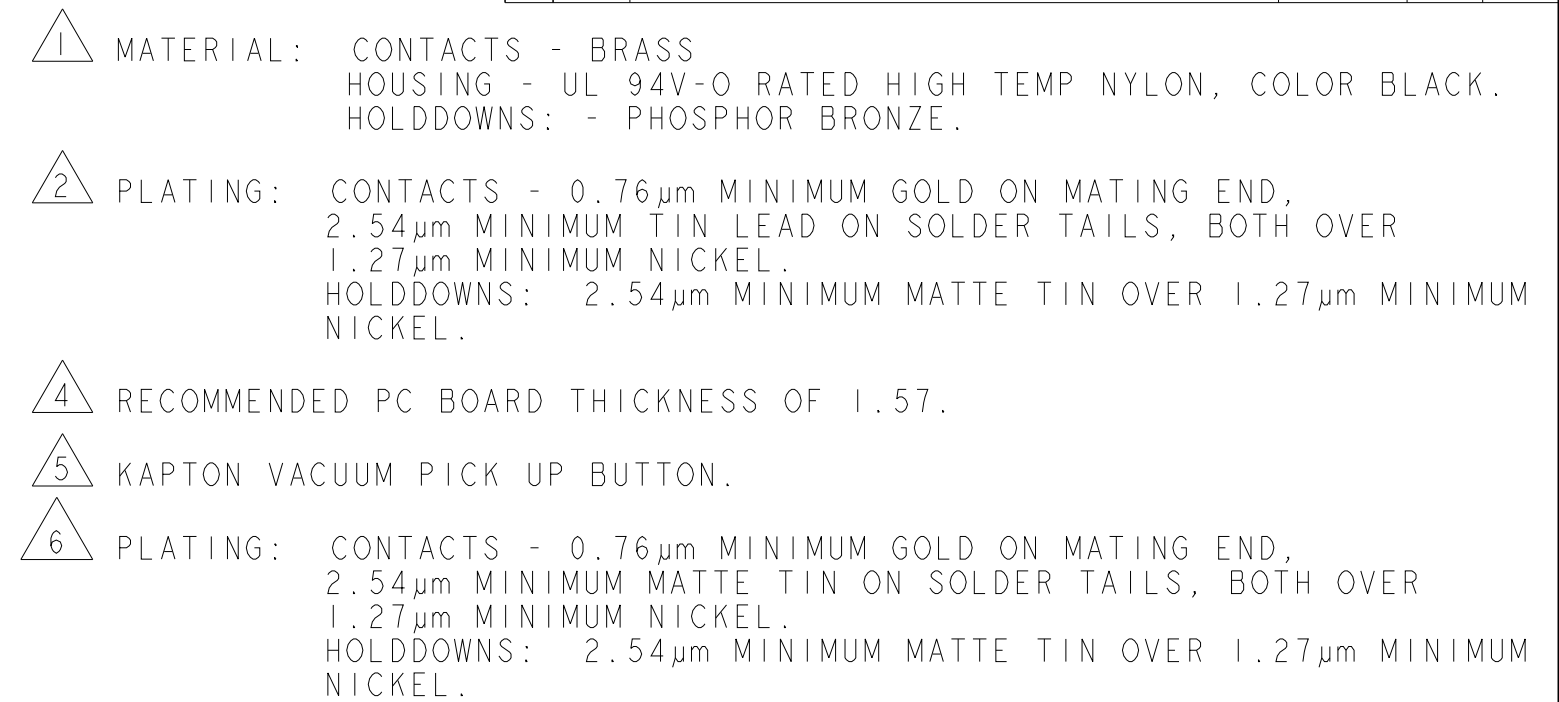

|                                                                                       |       |       |       |    |             |
|---------------------------------------------------------------------------------------|-------|-------|-------|----|-------------|
|    | 33.00 | 37.43 | 40.00 | 12 | 3-1445095-2 |
|    | 30.00 | 34.43 | 37.00 | 11 | 3-1445095-1 |
|    | 27.00 | 31.43 | 34.00 | 10 | 3-1445095-0 |
|    | 24.00 | 28.43 | 31.00 | 9  | 2-1445095-9 |
|    | 21.00 | 25.43 | 28.00 | 8  | 2-1445095-8 |
|   | 18.00 | 22.43 | 25.00 | 7  | 2-1445095-7 |
|  | 15.00 | 19.43 | 22.00 | 6  | 2-1445095-6 |
|  | 12.00 | 16.43 | 19.00 | 5  | 2-1445095-5 |
|  | 9.00  | 13.43 | 16.00 | 4  | 2-1445095-4 |
|  | 6.00  | 10.43 | 13.00 | 3  | 2-1445095-3 |
|  | 3.00  | 7.43  | 10.00 | 2  | 2-1445095-2 |

|                           |                                                                                       |       |       |       |    |                       |
|---------------------------|---------------------------------------------------------------------------------------|-------|-------|-------|----|-----------------------|
| SUPERSEDED BY 3-1445095-2 |  | 33.00 | 37.43 | 40.00 | 12 | <del>+1445095-2</del> |
| SUPERSEDED BY 3-1445095-1 |  | 30.00 | 34.43 | 37.00 | 11 | <del>+1445095-1</del> |
| SUPERSEDED BY 3-1445095-0 |  | 27.00 | 31.43 | 34.00 | 10 | <del>+1445095-0</del> |
| SUPERSEDED BY 2-1445095-9 |  | 24.00 | 28.43 | 31.00 | 9  | <del>+445095-9</del>  |
| SUPERSEDED BY 2-1445095-8 |  | 21.00 | 25.43 | 28.00 | 8  | <del>+445095-8</del>  |
| SUPERSEDED BY 2-1445095-7 |  | 18.00 | 22.43 | 25.00 | 7  | <del>+445095-7</del>  |
| SUPERSEDED BY 2-1445095-6 |  | 15.00 | 19.43 | 22.00 | 6  | <del>+445095-6</del>  |
| SUPERSEDED BY 2-1445095-5 |  | 12.00 | 16.43 | 19.00 | 5  | <del>+445095-5</del>  |
| SUPERSEDED BY 2-1445095-4 |  | 9.00  | 13.43 | 16.00 | 4  | <del>+445095-4</del>  |
| SUPERSEDED BY 2-1445095-3 |  | 6.00  | 10.43 | 13.00 | 3  | <del>+445095-3</del>  |
| SUPERSEDED BY 2-1445095-2 |  | 3.00  | 7.43  | 10.00 | 2  | <del>+445095-2</del>  |

| FINISH | DIM Z | DIM V | DIM W | NO. OF<br>POSN | PART NUMBER |
|--------|-------|-------|-------|----------------|-------------|
|--------|-------|-------|-------|----------------|-------------|



|                                                                                                            |  |                                                                                                                         |  |                                                                                                                      |  |
|------------------------------------------------------------------------------------------------------------|--|-------------------------------------------------------------------------------------------------------------------------|--|----------------------------------------------------------------------------------------------------------------------|--|
| THIS DRAWING IS A CONTROLLED DOCUMENT.                                                                     |  | DWN J ROOT 090CT2000<br>CHK 20-FEB-2001<br>K. WHITAKER<br>APVD 20-FEB-2001<br>C. JONES                                  |  |  TE Connectivity                |  |
| DIMENSIONS:<br>mm<br> |  | TOLERANCES UNLESS OTHERWISE SPECIFIED:<br>0 PLC ±<br>1 PLC ±<br>2 PLC ±0.13<br>3 PLC ±<br>4 PLC ±<br>ANGLES ±<br>FINISH |  | NAME<br>VERTICAL SURF MOUNT HEADER ASSY,<br>30 MIC GOLD CONTACTS, THRU HOLE<br>HOLDDOWNS, SGL ROW, MICRO MATE-N-LOK™ |  |
| MATERIAL<br>          |  | PRODUCT SPEC<br>-<br>APPLICATION SPEC<br>-<br>WEIGHT -                                                                  |  | SIZE<br>A2<br>CAGE CODE<br>00779<br>DRAWING NO<br>C-1445095<br>RESTRICTED TO<br>-                                    |  |
| SEE TABLE                                                                                                  |  | CUSTOMER DRAWING                                                                                                        |  | SCALE 5:1<br>SHEET 1 OF 1<br>REV C1                                                                                  |  |

# Mouser Electronics

Authorized Distributor

Click to View Pricing, Inventory, Delivery & Lifecycle Information:

[TE Connectivity:](#)

[2-1445095-9](#)