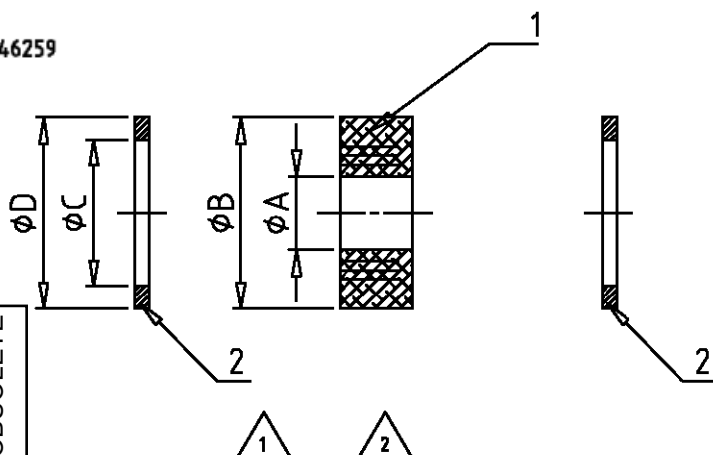


MATED WITH: PASSEND ZU:	LOC	DIST	REVISIONS ÄNDERUNGEN					
—	AI	—	P	LTR	DESCRIPTION BESCHREIBUNG	DATE	DWN	APVD
PROJEKT NR.1 —				A2	DIN 46320-1 war DIN 46320 Eg00-0555-01	21.08.98	GG	SM
				A3	ECR-17-014011	28MAR18	SG	MKO

Maße nach DIN 46320 -1 / DIN 46259

[illegible]

QUANTITY / STÜCK	DESCRIPTION / BENENNUNG	MATERIAL	SURFACE / OBERFLÄCHE	ØA	ØB	ØC	ØD	ITEM NO. POS.	NOTE / BEMERKUNG
				DIMENSION / ABMESSUNG					

ORDERING NO. / BESTELLNUMMER

~~ASD.11.N~~

~~ASD-13-N~~

ASD.16.N

ASD.21.N

ASD.29.N

~~ASD.36.N~~

~~ASD.42.N~~

DIMENSIONS: DIMENSIONEN: mm		DWN Kramer 04.06.98	MATERIAL 1		FINISH OBERFLAECH/FARBE 2	
TOLERANCES UNLESS OTHERWISE SPECIFIED: ALLGEMEINTOLERANZEN n. ISO 8015 n. ISO 2768 - mH -E n. DIN 16901 - 140 0 PLC 1 PLC 2 PLC 3 PLC ANGLES /WINKEL °-		CHK Braun 05.06.98	TE TE Connectivity			
		APVD -				
		PRODUCT SPEC PRODUKTSPEZ. -	NAME Cut-out Sealing ring Ausschneidbarer Dichtring Set			
		APPLICATION SPEC VERARBEITUNGSSPEZ. -				
		WEIGHT GEWICHT -	SIZE A4	CAGE CODE 00779	DRAWING NO ZEICHNUNGS-NR. C=1106050	RESTRICTED TO NUR FUER -
		CUSTOMER DRAWING /KUNDENZEICHNUNG				
		MASSSTAB 1:1		BLATT 1	OF VON 1	A3

Mouser Electronics

Authorized Distributor

Click to View Pricing, Inventory, Delivery & Lifecycle Information:

[TE Connectivity:](#)

[3-1106050-1](#)