


STATO DI FORNITURA  
(SUPPLY CONDITION)


SCALA NON IMPEGNATIVA  
(DO NOT SCALE)  
DIMENSIONI IN mm  
(DIMENSIONS IN)

METRIC

PROIEZIONE EUROPEA  
(EUROPEAN PROJECTION)

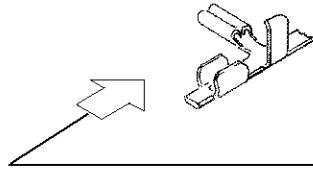

SENSO DI USCITA DEL TERMINALE  
DALLA BOBINA  
(DIRECTION OFF TOP OF REEL)

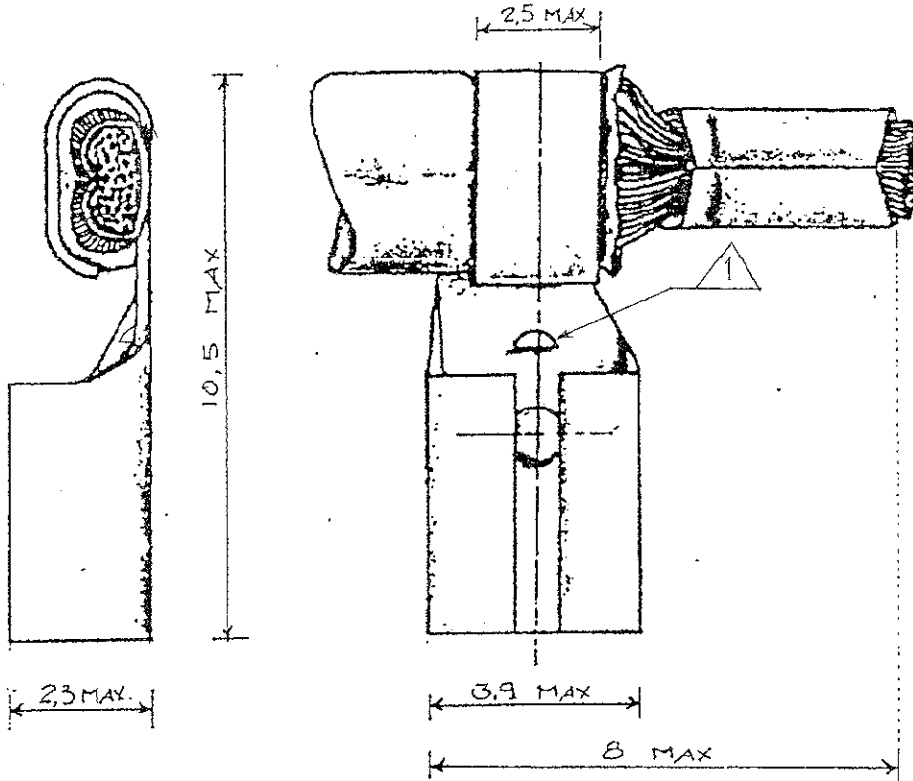

1 VERSIONE SENZA BUGNA, RISERVATA AL CLIENTE TRW ITALIA.  
(NO TAB STOP VERSION. RESTRICTED FOR CUSTOMER TRW ITALIA).

2 OBSOLETE PARTS: OBSOLETE CIS STREAMLINING PER D.RENAUD/D.SINISI

2	1	0.43-0.35	PRESTAGNATO (PRE-TIN PLATED)	OTTONE (BRASS)	<del>0-141352-2</del>	R
		0.71-0.63	PRESTAGNATO (PRE-TIN PLATED)	BRONZO FOSF. (PHOS. BZ.)	0-141352-6	R
2		0.71-0.63	NUDO (PLAIN)	BRONZO FOSF. (PHOS. BZ.)	<del>0-141352-5</del>	R
		0.71-0.63	PRESTAGNATO (PRE-TIN PLATED)	OTTONE (BRASS)	0-141352-4	R
		0.71-0.63	NUDO (PLAIN)	OTTONE (BRASS)	0-141352-3	R
		0.43-0.35	PRESTAGNATO (PRE-TIN PLATED)	OTTONE (BRASS)	0-141352-2	R
		0.43-0.35	NUDO (PLAIN)	OTTONE (BRASS)	0-141352-1	R
NOTE		LUCE (GAP SIZE)	FINITURA / COLORE (FINISH / COLOUR)	MATERIALE (MATERIAL)	NUMERO (CAMP P/ND)	REV

CUSTOMER DWG.  
FOR REFERENCE ONLY

DISEGNO PER CLIENTE  
SOLO PER RIFERIMENTO

THIS DRAWING IS UNPUBLISHED - RELEASE FOR PUBLICATION 19  
© COPYRIGHT 19 BY AMP INCORPORATED, HARRISBURG, PA. ALL INTERNATIONAL RIGHT RESERVED. AMP PRODUCTS MAY BE COVERED BY U.S. AND FOREIGN PATENT AND/OR PATENT PENDING

TOLLERANZE, SE NON DIVERSAMENTE SPECIFICATO  
(TOLERANCES, UNLESS OTHERWISE SPECIFIED)

DIAM. ISOLANTE (INS. DIA. RANGE)	RANGO FILO (WIRE RANGE)	SCALA (SCALE)
1.6-2.5 mm	mm <sup>2</sup> 0.3-0.8	-

R4	ECR-10-011338	PKS	27MAY10	ANGOLI (ANGLES)	± 0.3 ± 2°	<p>TE ITALIA S.p.A. Corso F.lli Cervi, 15 COLLEGNO (TORINO)</p>
R3	ECO-10-000030	KK	05JAN10	DIS. H. YAALI (DR.)	20 MAY 99	
R2	ADDED NEW PART ET00-0085-03	H.Y.	29 MAY 03	CONT. C. TARTARI (CHK)	20 MAY 99	DESCRIZIONE (DESCRIPTION)
R1	ADDED DIMENSION ET00-0247-01	H.Y.	12 OCT 01			FASTON Connector .110 sr. FLAG REC. CTC.
P	REVISED & REDRAWN ET00-0176-99	H.Y.	01 JAN 99			LOC. SIZE NUMERO (DWG NO)
REV. (REV. LTR.)	REVISIONI (REVISION RECORD)	DIS. (DR)	DATA (DATE)	APP. (APP.)		I A4 C-141352 R4 1 DI (OF) 1

Lead Free Conversion in Process - Refer to  
Specification 230-700 at [www.tycoelectronics.com/leadfree](http://www.tycoelectronics.com/leadfree)

# Mouser Electronics

Authorized Distributor

Click to View Pricing, Inventory, Delivery & Lifecycle Information:

[TE Connectivity:](#)

[141352-4](#)