

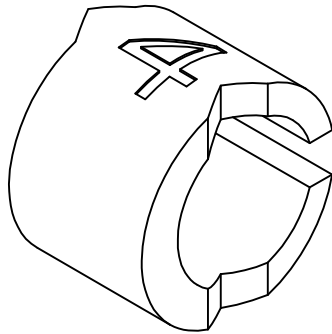
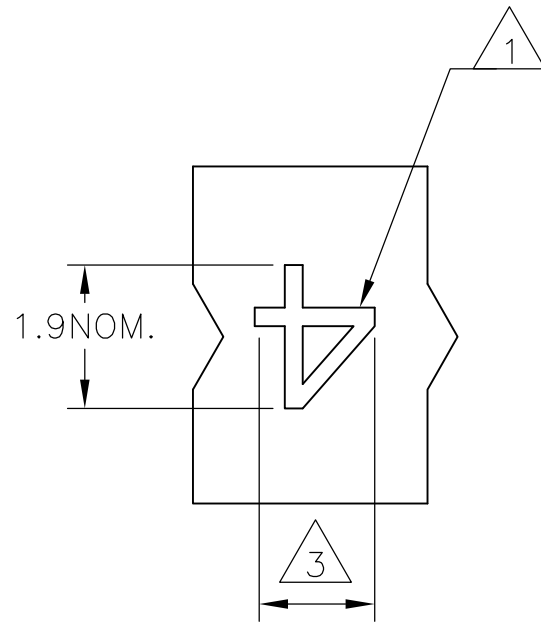
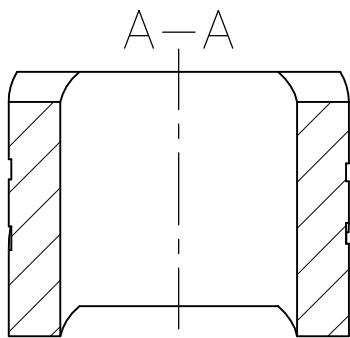
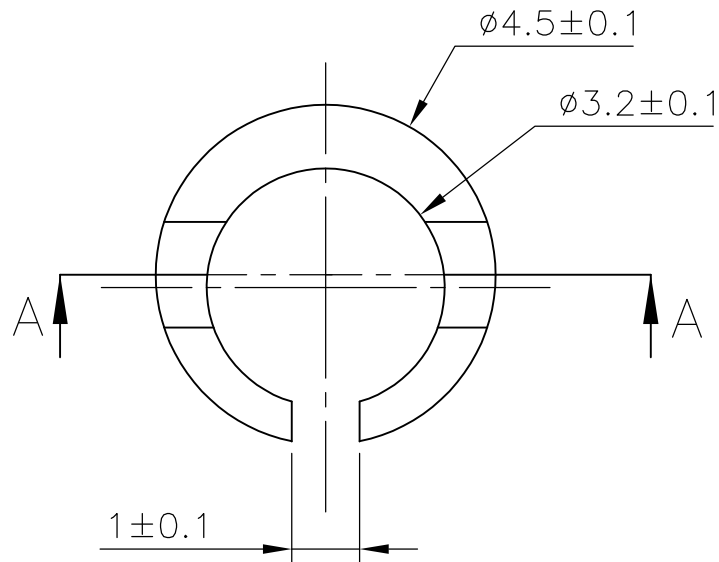


| REVISIONS |     |                                         |           |     |      |
|-----------|-----|-----------------------------------------|-----------|-----|------|
| P         | LTR | DESCRIPTION                             | DATE      | DWN | APVD |
|           | 4   | STRIKE THROUGH OBS PARTS. ECR-16-009538 | 05JAN2017 | AFK | LS   |

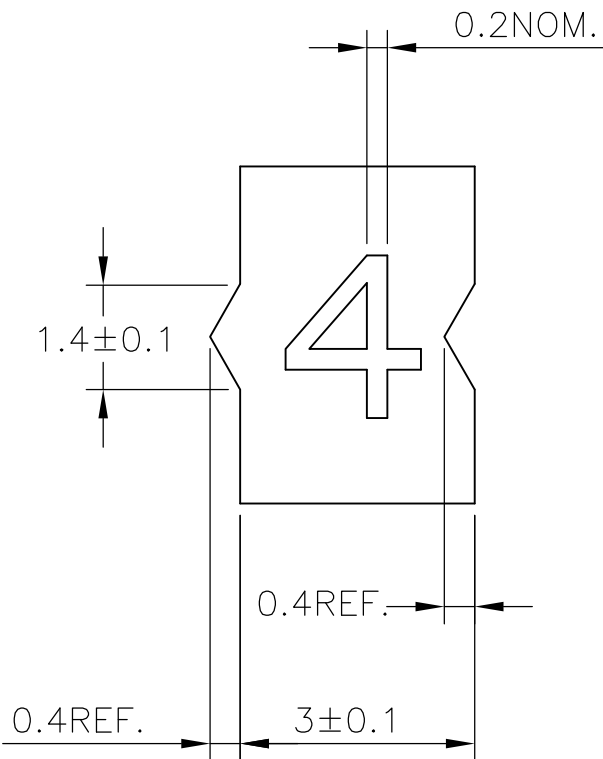

- NOTES:
- 1 FOR PART NUMBERS SEE SHEET 3 OF 3.
  - 2 MARK SHOULD BE CENTRALLY POSITIONED ±0.1 mm
  - 3 WIDTH OF MARK DEPENDS ON CHARACTER PRINTED

|                                        |  |                                    |                                                                                                       |                    |                             |
|----------------------------------------|--|------------------------------------|-------------------------------------------------------------------------------------------------------|--------------------|-----------------------------|
| THIS DRAWING IS A CONTROLLED DOCUMENT. |  | DWN<br>RAGHAVENDRA K<br>23MAR2013  |  TE Connectivity |                    |                             |
|                                        |  | CHK<br>KEAN ALAN<br>23MAR2013      |                                                                                                       |                    |                             |
|                                        |  | APVD<br>MARIO APPELLO<br>23MAR2013 | NAME<br>SNAP-ON MARKER STB/STD 09 WITH APPLICATOR                                                     |                    |                             |
|                                        |  | PRODUCT SPEC                       |                                                                                                       |                    |                             |
|                                        |  | APPLICATION SPEC                   |                                                                                                       |                    |                             |
|                                        |  | WEIGHT<br>0                        | SIZE<br>A3                                                                                            | CAGE CODE<br>00779 | DRAWING NO<br>C-1-1198185-1 |
|                                        |  | CUSTOMER DRAWING                   |                                                                                                       | SCALE<br>NTS       | SHEET<br>1 OF 3             |
|                                        |  |                                    |                                                                                                       | REV<br>4           |                             |

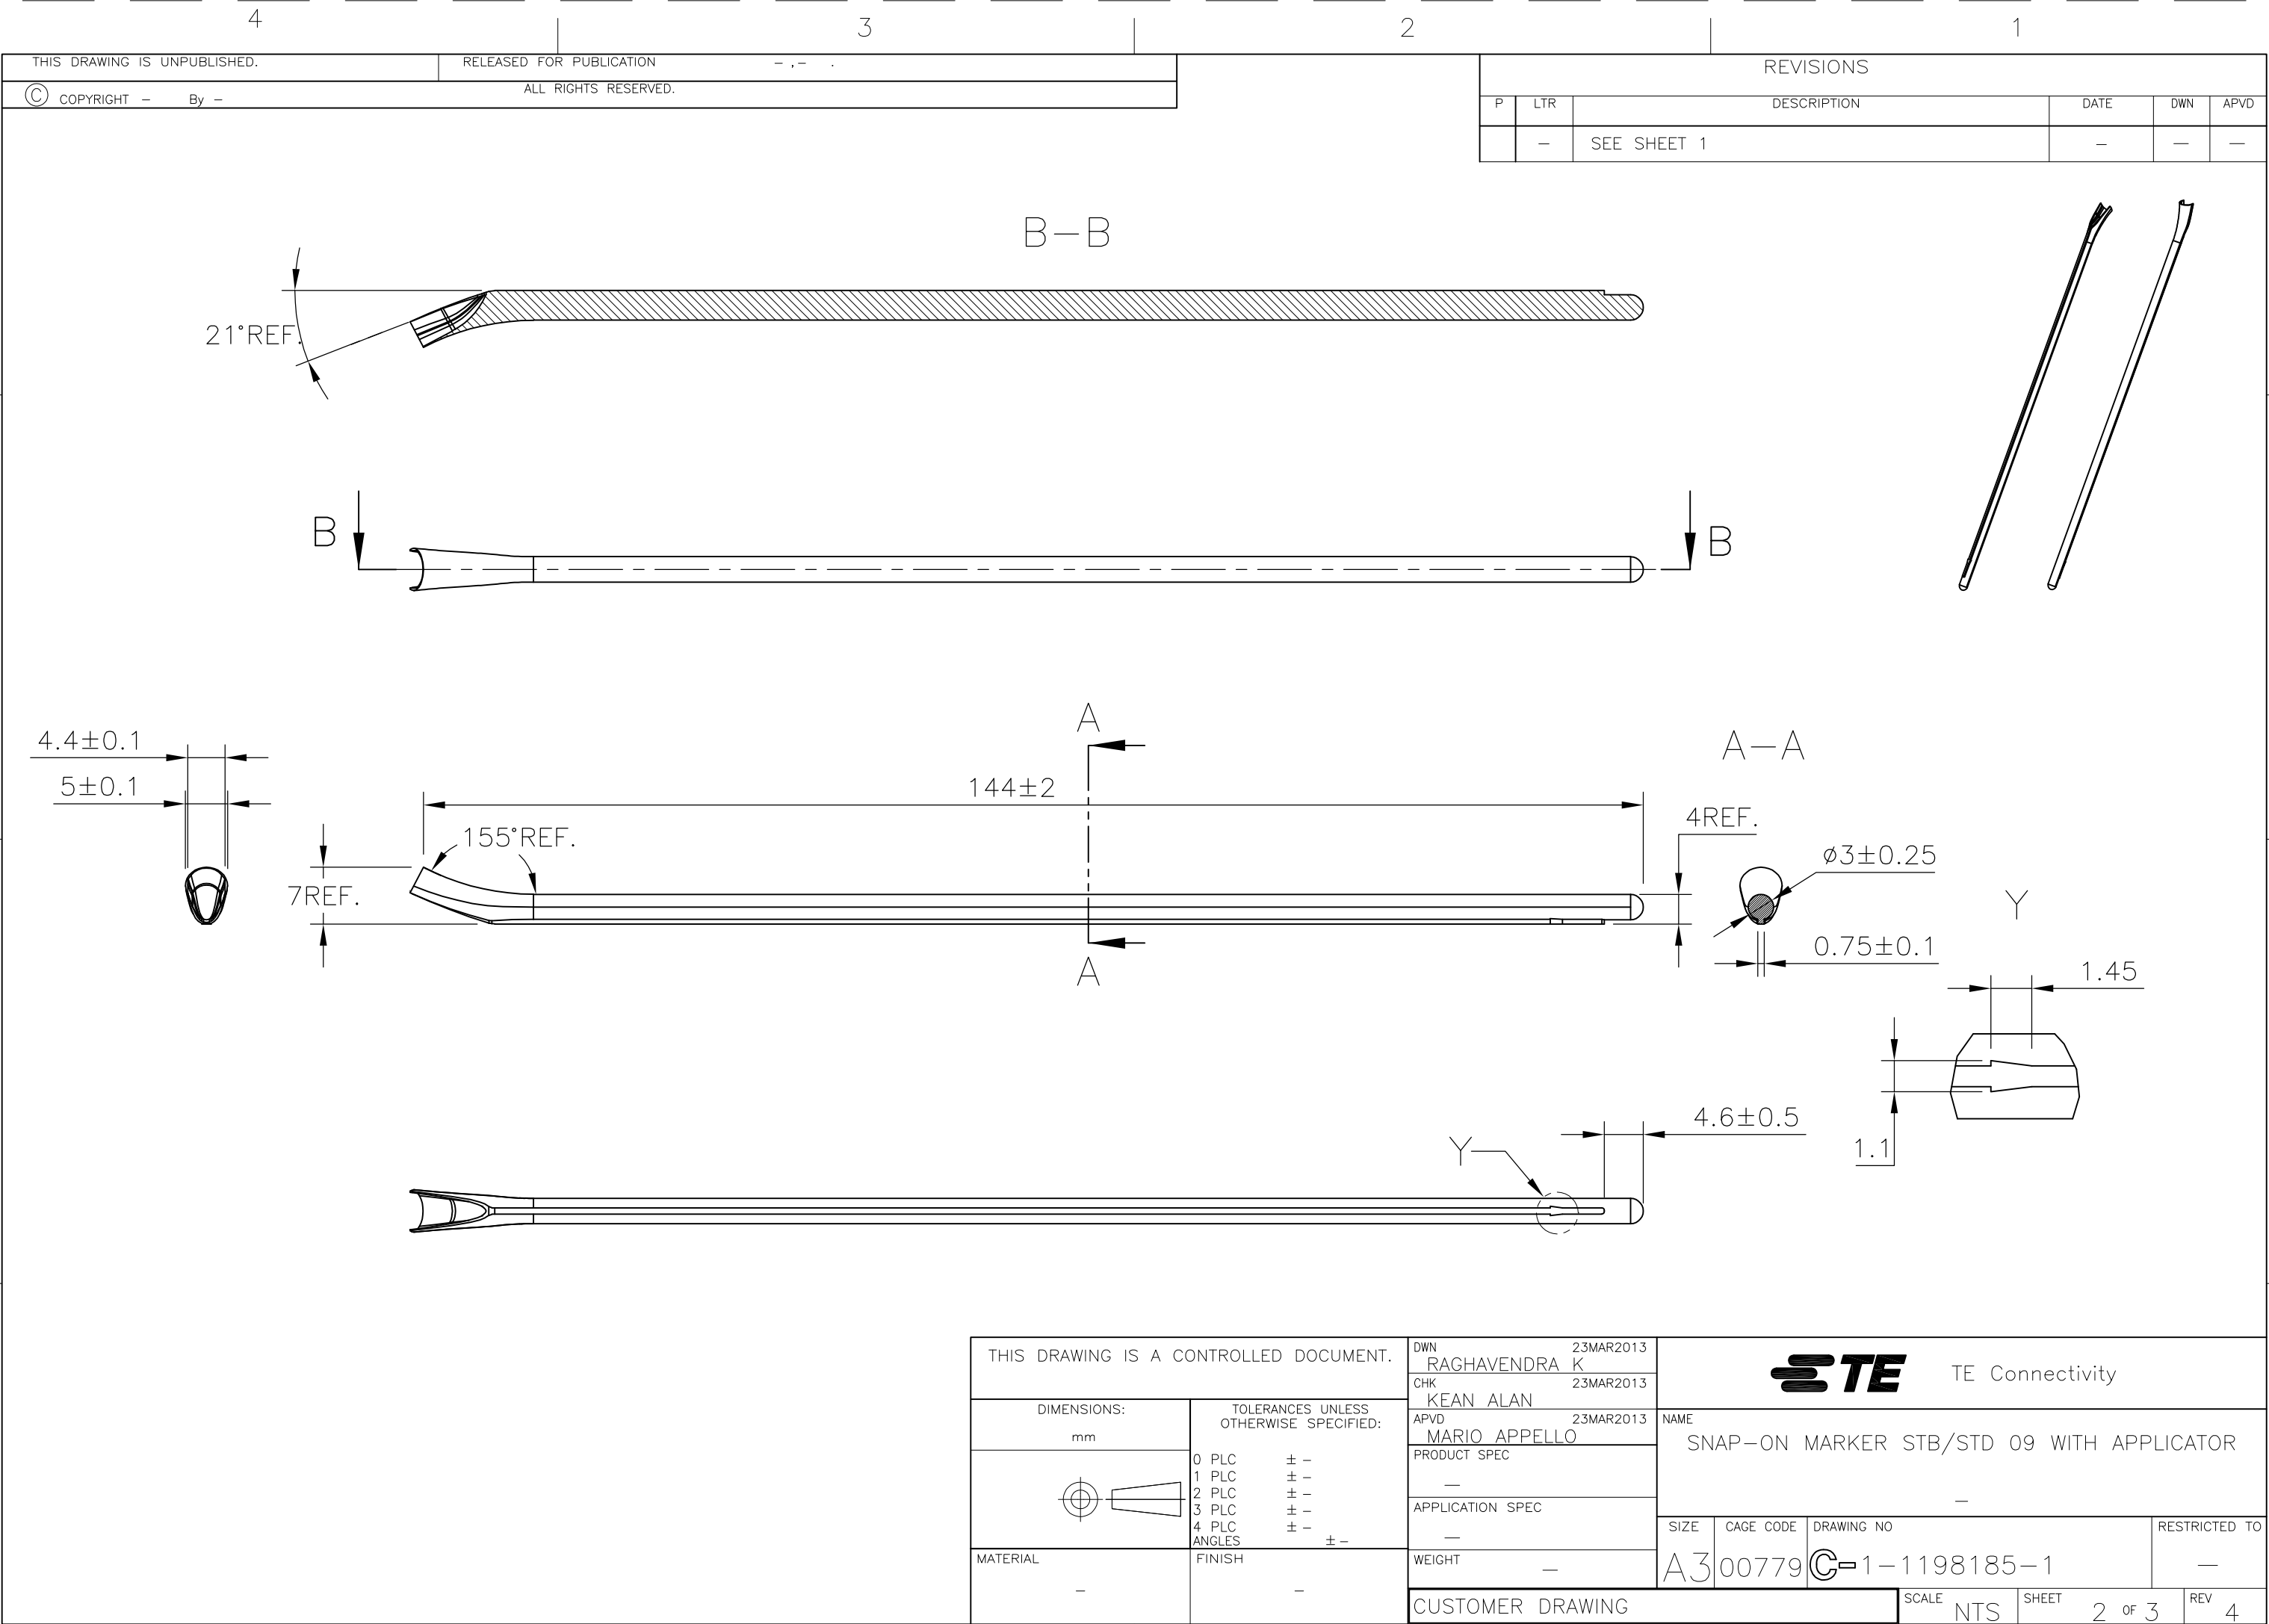

| REVISIONS |     |             |      |     |      |
|-----------|-----|-------------|------|-----|------|
| P         | LTR | DESCRIPTION | DATE | DWN | APVD |
|           | —   | SEE SHEET 1 | —    | —   | —    |

| DESCRIPTION   | PART NO.    |
|---------------|-------------|
| STB09-0-0     | 1768039-4   |
| STB09-1-1     | 1768039-6   |
| STB09-2-2     | 1768039-9   |
| STB09-3-3     | 1-1768039-2 |
| STB09-5-5     | 1-1768039-6 |
| STB09-6-6     | 1-1768039-8 |
| STB09-7-7     | 1-1768039-9 |
| STB09-8-8     | 2-1768039-0 |
| STB09-BLANK-0 | 2-1768039-4 |
| STB09-BLANK-1 | 2-1768039-5 |
| STB09-BLANK-2 | 2-1768039-6 |
| STB09-BLANK-3 | 2-1768039-7 |
| STB09-BLANK-5 | 2-1768039-8 |
| STB09-BLANK-6 | 2-1768039-9 |
| STB09-BLANK-7 | 3-1768039-0 |
| STB09-BLANK-8 | 3-1768039-1 |
| STD09W/1-12   | 7-1768710-9 |
| STD09W/SA     | 3-1768044-5 |
| STD09W/SAB    | 3-1768044-6 |
| STD09W-0      | 808756-000  |
| STD09W-1      | 564314-000  |
| STD09W-2      | 881128-000  |
| STD09W-3      | 451612-000  |
| STD09W-4      | 776688-000  |
| STD09W-5      | 411220-000  |
| STD09W-6      | 062724-000  |
| STD09W-7      | 638470-000  |




| DESCRIPTION            | PART NO.               |
|------------------------|------------------------|
| STD09W-8               | 671050-000             |
| STD09W-9               | 519158-000             |
| STD09W-A               | 317872-000             |
| <del>STD09W-A-LC</del> | <del>3-1768044-9</del> |
| STD09W-B               | 929926-000             |
| STD09W-BLANK           | 4-1768044-0            |
| <del>STD09W-B-LC</del> | <del>4-1768044-1</del> |
| STD09W-C               | 595148-000             |
| STD09W-COLON           | 950990-000             |
| STD09W-D               | 535494-000             |
| <del>STD09W-D-LC</del> | <del>4-1768044-2</del> |
| STD09W-DOT             | 4-1768044-3            |
| STD09W-E               | 318782-000             |
| STD09W-EARTH           | 4-1768044-4            |
| STD09W-F               | 778086-000             |
| STD09W-G               | 362886-000             |
| STD09W-H               | 659958-000             |
| STD09W-I               | 234392-000             |
| STD09W-J               | 429560-000             |
| STD09W-K               | 594054-000             |
| <del>STD09W-K-LC</del> | <del>5-1768044-0</del> |
| STD09W-L               | 591020-000             |
| <del>STD09W-L-LC</del> | <del>5-1768044-1</del> |
| STD09W-M               | 853188-000             |
| STD09W-MINUS           | 5-1768044-2            |
| STD09W-N               | 547972-000             |
| STD09W-P               | 294582-000             |

| DESCRIPTION  | PART NO.    |
|--------------|-------------|
| STD09W-PLUS  | 5-1768044-5 |
| STD09W-Q     | 702368-000  |
| STD09W-R     | 071620-000  |
| STD09W-S     | 701134-000  |
| STD09W-SLASH | 190726-000  |
| STD09W-T     | 594256-000  |
| STD09W-U     | 588548-000  |
| STD09W-V     | 651644-000  |
| STD09W-W     | 910358-000  |
| STD09W-X     | 697154-000  |
| STD09W-Y     | 068920-000  |
| STD09W-Z     | 952914-000  |
| STD09Y-0     | 047316-000  |
| STD09Y-1     | 064090-000  |
| STD09Y-2     | 700690-000  |
| STD09Y-3     | 410908-000  |
| STD09Y-4     | 422172-000  |
| STD09Y-5     | 131226-000  |
| STD09Y-6     | 746782-000  |
| STD09Y-7     | 007980-000  |
| STD09Y-8     | 634544-000  |
| STD09Y-9     | 645636-000  |
| STD09Y-A     | 862816-000  |
| STD09Y-AC    | 6-1768044-0 |
| STD09Y-B     | 036610-000  |
| STD09Y-BLANK | 6-1768044-2 |
| STD09Y-C     | 452642-000  |

| DESCRIPTION  | PART NO.    |
|--------------|-------------|
| STD09Y-COLON | 6-1768044-4 |
| STD09Y-D     | 281690-000  |
| STD09Y-DOT   | 6-1768044-6 |
| STD09Y-E     | 882530-000  |
| STD09Y-EARTH | 6-1768044-7 |
| STD09Y-F     | 017172-000  |
| STD09Y-G     | 112902-000  |
| STD09Y-H     | 075034-000  |
| STD09Y-I     | 769976-000  |
| STD09Y-J     | 327448-000  |
| STD09Y-K     | 672532-000  |
| STD09Y-L     | 509762-000  |
| STD09Y-M     | 205508-000  |
| STD09Y-MINUS | 7-1768044-5 |
| STD09Y-N     | 667860-000  |
| STD09Y-P     | 597516-000  |
| STD09Y-PLUS  | 7-1768044-8 |
| STD09Y-Q     | 247002-000  |
| STD09Y-R     | 920140-000  |
| STD09Y-S     | 590022-000  |
| STD09Y-T     | 497634-000  |
| STD09Y-U     | 491394-000  |
| STD09Y-V     | 423154-000  |
| STD09Y-W     | 365646-000  |
| STD09Y-X     | 523918-000  |
| STD09Y-Y     | 362942-000  |
| STD09Y-Z     | 322370-000  |

 OBSOLETE PART
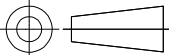
|                                                                                       |  |                                        |  |                                                                                                       |  |
|---------------------------------------------------------------------------------------|--|----------------------------------------|--|-------------------------------------------------------------------------------------------------------|--|
| THIS DRAWING IS A CONTROLLED DOCUMENT.                                                |  | DWN 23MAR2013<br>RAGHAVENDRA K         |  |  TE Connectivity |  |
|                                                                                       |  | CHK 23MAR2013<br>KEAN ALAN             |  |                                                                                                       |  |
| DIMENSIONS:<br>mm                                                                     |  | TOLERANCES UNLESS OTHERWISE SPECIFIED: |  | NAME<br>SNAP-ON MARKER STB/STD 09 WITH APPLICATOR                                                     |  |
|  |  | 0 PLC ± -                              |  | APVD 23MAR2013<br>MARIO APPELLO                                                                       |  |
|                                                                                       |  | 1 PLC ± -                              |  | PRODUCT SPEC                                                                                          |  |
|                                                                                       |  | 2 PLC ± -                              |  | APPLICATION SPEC                                                                                      |  |
|                                                                                       |  | 3 PLC ± -                              |  | SIZE                                                                                                  |  |
|                                                                                       |  | 4 PLC ± -                              |  | CAGE CODE                                                                                             |  |
|                                                                                       |  | ANGLES ± -                             |  | DRAWING NO                                                                                            |  |
| MATERIAL                                                                              |  | FINISH                                 |  | RESTRICTED TO                                                                                         |  |
| -                                                                                     |  | -                                      |  | -                                                                                                     |  |
| CUSTOMER DRAWING                                                                      |  |                                        |  | SCALE NTS                                                                                             |  |
|                                                                                       |  |                                        |  | SHEET 3 OF 3                                                                                          |  |
|                                                                                       |  |                                        |  | REV 4                                                                                                 |  |

# Mouser Electronics

Authorized Distributor

Click to View Pricing, Inventory, Delivery & Lifecycle Information:

[TE Connectivity:](#)

[STD09W-V](#)