



						GOLD FLASH	5-1734100-8		
125.65	123.01 [4.843]	121.37	90	180	91	0.381mm[15m"]	3-1734100-8	180	
_ <del></del>	[4.040]	[4.770]					1 1734100 8		
112.95 [4.447]	110.31 [4.343]	108.67 [4.278]	80	160	81	10	7-1734100-6		
	[]					GOLD FLASH	5-1734100-6		
112.95	110.31	108.67	80	160	81	0.381mm[15m"]	3-1734100-6	160	
[4.447]	[4.343]	[4.278]					1-1734100-6		
						GOLD FLASH	5-1734100-3		
93.90	91.26	89.62	65	130	66	0.381mm[15m"]	3-1734100-3	130	
[3.697]	[3.593]	[3.528]			00			100	
							1-1734100-3		
87.55	84.91	83.27		1 0 0	~ 1	GOLD FLASH	5-1734100-2	1.2.0	
[3.447]			60	120	61	0.381mm[15m"]	3-1734100-2	120	
						<u> 10</u>	1-1734100-2		
74 95	72.21	70.57				GOLD FLASH	5-1734100-1		
74.85 [2.947]			50	100	51	0.381mm[15m"]	3-1734100-1		
						10	1-1734100-1	100	
						GOLD FLASH	5-1734100-0		
74.85 [2.947]	72.21 [2.843]	70.57 [2.778]	50	100	51	0.381mm[15m"]	3-1734100-0		$\sim$
	L	L1				10	1-1734100-0		C
						GOLD FLASH	4-1734100-9		
62.15	59.51 [2.343]	57.87	40	80	41	0.381mm[15m"]	2-1734100-9	80	
[2.447]	[2.545]	[2.270]				10	1734100-9	ß	
						GOLD FLASH	4-1734100-8		
62.15	59.51	57.87	40	80	41	0.381mm[15m"]	2-1734100-8	80	
[2.447]	[2.343]	[2.278]				<u> </u>	1734100-8		
54.53	51.89	50.25			75	GOLD FLASH	4-1734100-7		
[2.147]	[2.043]	[1.978]	34	68	35	0.381mm[15m"]	2-1734100-7	68	
						10	1734100-7		
49.45	46.81	45.17				GOLD FLASH	4-1734100-6		
[1.947]			30	60	31	0.381mm[15m"]	2-1734100-6	60	
						10	1734100-6		
	10.10	70.00				GOLD FLASH	5-1734100-9		
43.10	40.46	38.82	25	50	26	0.381mm[15m"]	3-1734100-9		
						10	1-1734100-9	50	
						GOLD FLASH	4-1734100-5	50	
43.10 [1.697]	40.46 [1.593]	38.82 [1.528]	25	50	26	0.381mm[15m"]	2-1734100-5		R
[1.037]	[1.000]	[1.020]				10	1734100-5		
						GOLD FLASH	4-1734100-4		
36.75	34.11	32.47	20	40	21	0.381mm[15m"]	2-1734100-4	40	
[1.447]	[1.343]	[1.278]					1734100-4		
						GOLD FLASH	4-1734100-3		
30.40	27.76	_26.12	15	30	16	0.381mm[15m]	2-1734100-3	30	
[1.197]	[1.093]	[1.025]		00	10				
						GOLD FLASH	1734100-3 4-1734100-2		
24.05	21.41	19.77	10	20	11			20	
24.05 [.947]	[.843]	[.778]		20		0.381mm[15m"]	2-1734100-2	20	
							1734100-2		
С	В	A	6 <u>A</u>	J₿	H	CONTACT PLATED	PART NUMBER	POS.	
			×.						
		TE			ΤE	Connectivit	У		
	ΡL	UG A	4SS	SEN	1BL	Y, VERTICAL			
						-BOARD,			A
		CHAN	1P	.0	50,	SERIES I			
GE CO	DE DRA	WING NO	)				RESTRIC	TED TO	
077	′9 <b>(C</b> ;	<b>-</b> 17	34	11(	00			-	
			_	ALE		SHEET	REV		
					_	1	OF 4	Ε	

REVISIONS			
DESCRIPTION	DATE	DWN	APVD
0-15-011028	2NOV2015	RG	SH

D

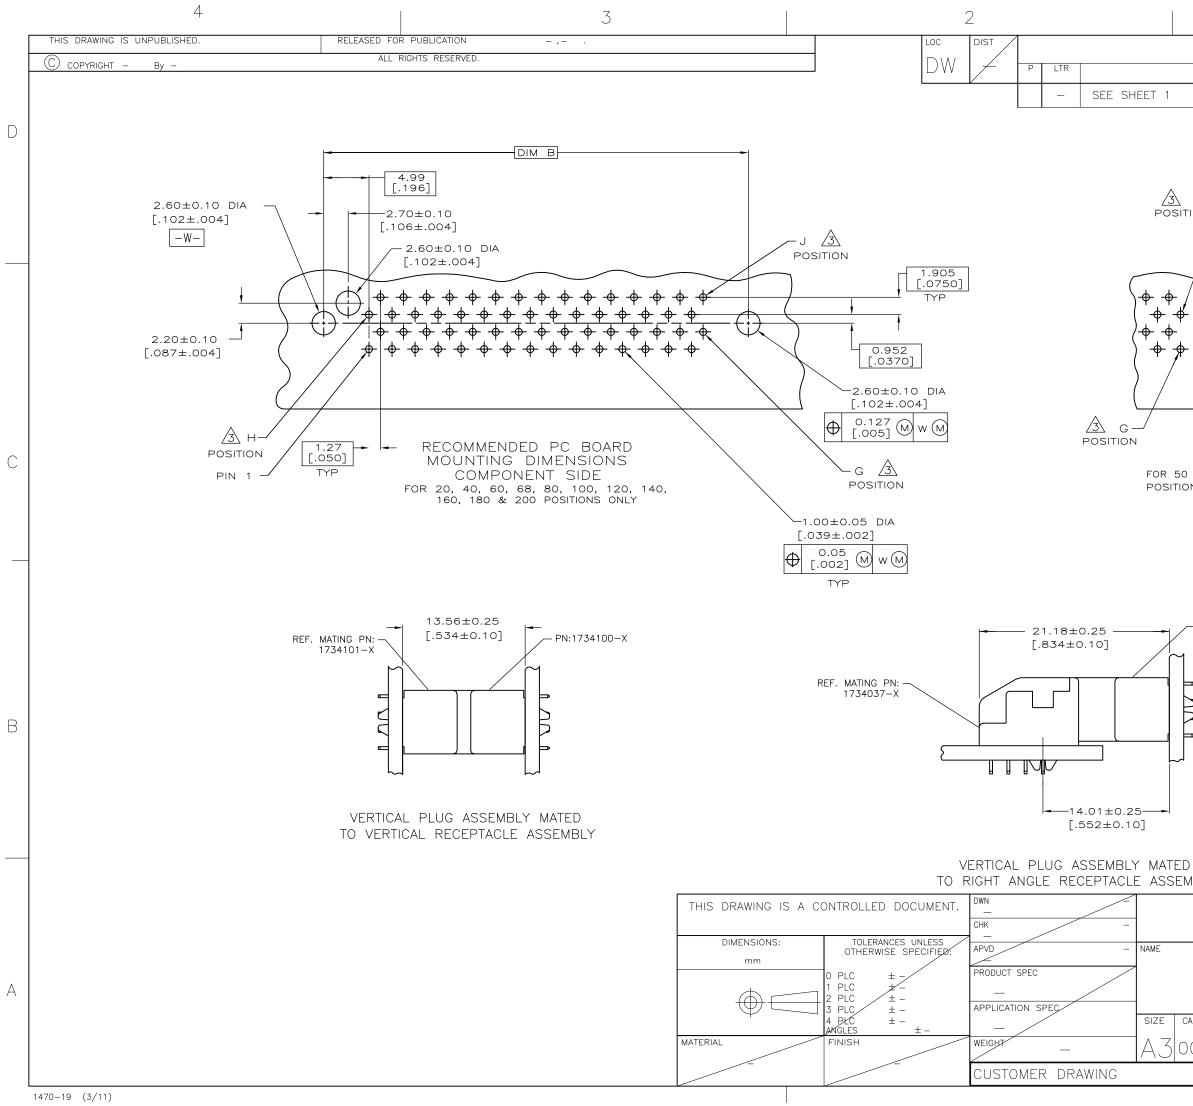


1				
REVISIONS				
DESCRIPTION	DATE	DWN	APVD	
	_			
				D
1				
$ \longrightarrow $				
$\Delta$				
$ \qquad \qquad$				
				С
AND 130 DNS ONLY				
— PN:1734100–X				
יי ב				
				В
) //BLY				
ETE TE Conne	ectivity			
PLUG ASSEMBLY, VEF	RTICAL			
BOARD-TO-BOAR				А
CHAMP .050, SERIE age code   drawing no		RESTRIC	TED TO	
0779 <b>C=</b> 1734100		/-	_	
SCALE SHE	iet2 of ∠	REV	É E	

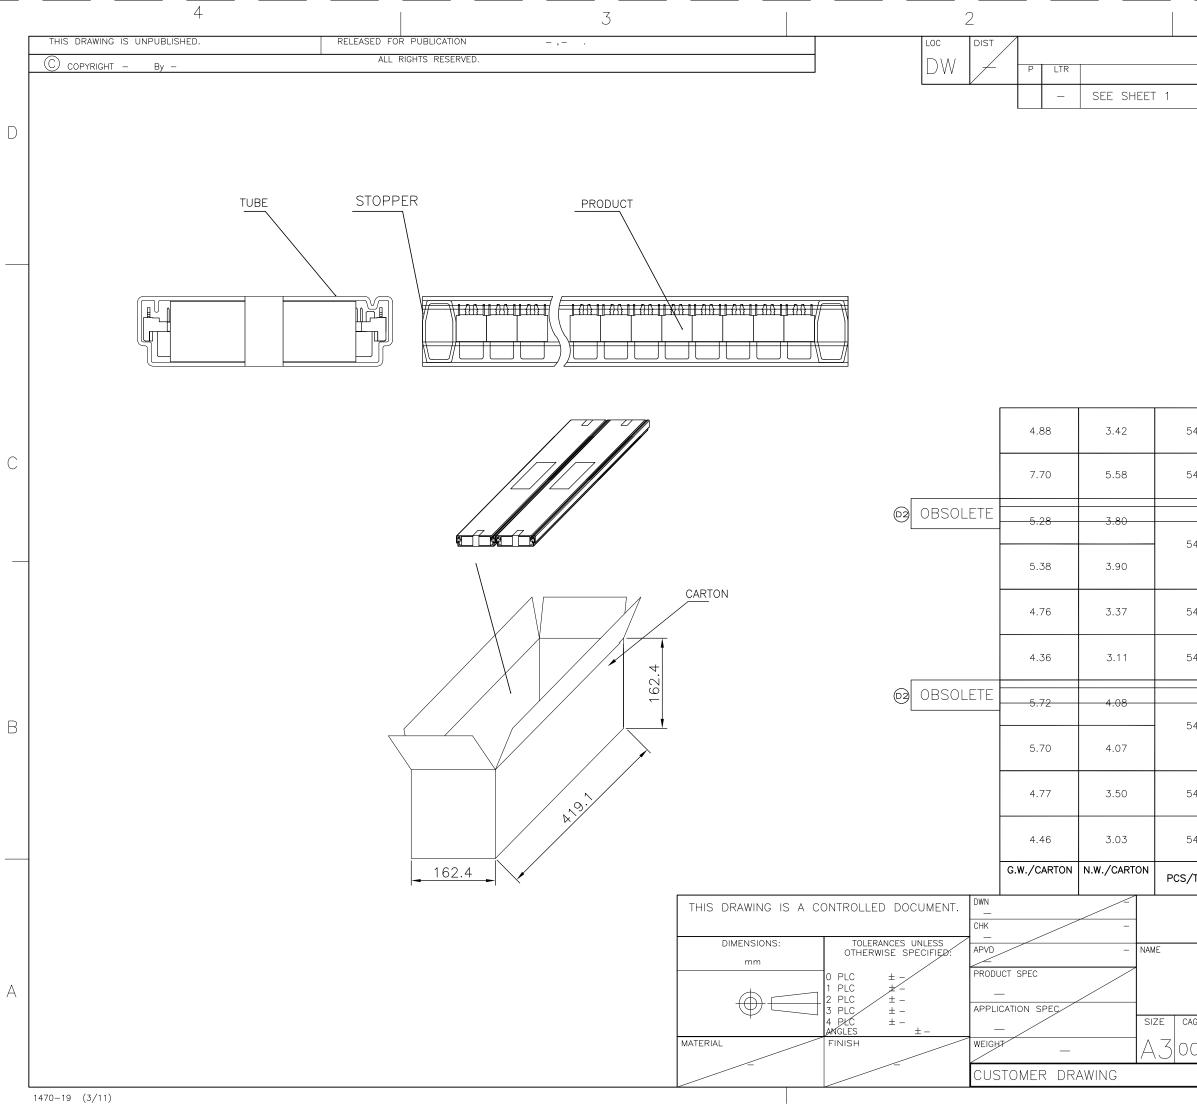

DES	CRIPTION		۵	DATE	DWN	APVD	
				_	_	_	
		I					
							D
				5-1734	1100-2		
4	8	432		3-173-		120	
				1-1734			
	10	0.01		5-1734		-	С
4	16	864		3-1734 1-1734		100	
				4-1734		-	
				2-1734	+100 <u>-</u> 9		
4	16	864		17341		80	
				4-1734 2-1734		-	
				17341		-	
				4-1734			
4	16	864		2-1734		68	
				17341 4-1734			
4	16	864			100-6	60	
				17341			
				5-1734		-	
				<del>3-1734</del> 1-1734			_
4	24	1296		4-1734		50	B
				2-1734			
				17341 4-1734			
4	24	1296		2-1734		40	
				17341			
		1000		4-1734		- 70	
4	24	1296		2-1734 17341		30	
		QUANTITY/CAR	TON			500	
TUBE	TUBES/CARTON	(PCS)		PARIN	NUMBER	POS.	
		<b>TC</b> 0		• •			
	e te	TE Conne	ectiv	nty			
	PLUG ASSE	EMBLY, VER	TICA	4L			
	BOARD-	-TO-BOAR	),				A
		050, SERIE					
GE CODE					RESTRIC	TED TO	1
077C	<b>C-</b> 1734	100			/_	_	
0//3			T		REV		
			_ '	3 OF 2	1	E	

REVISIONS

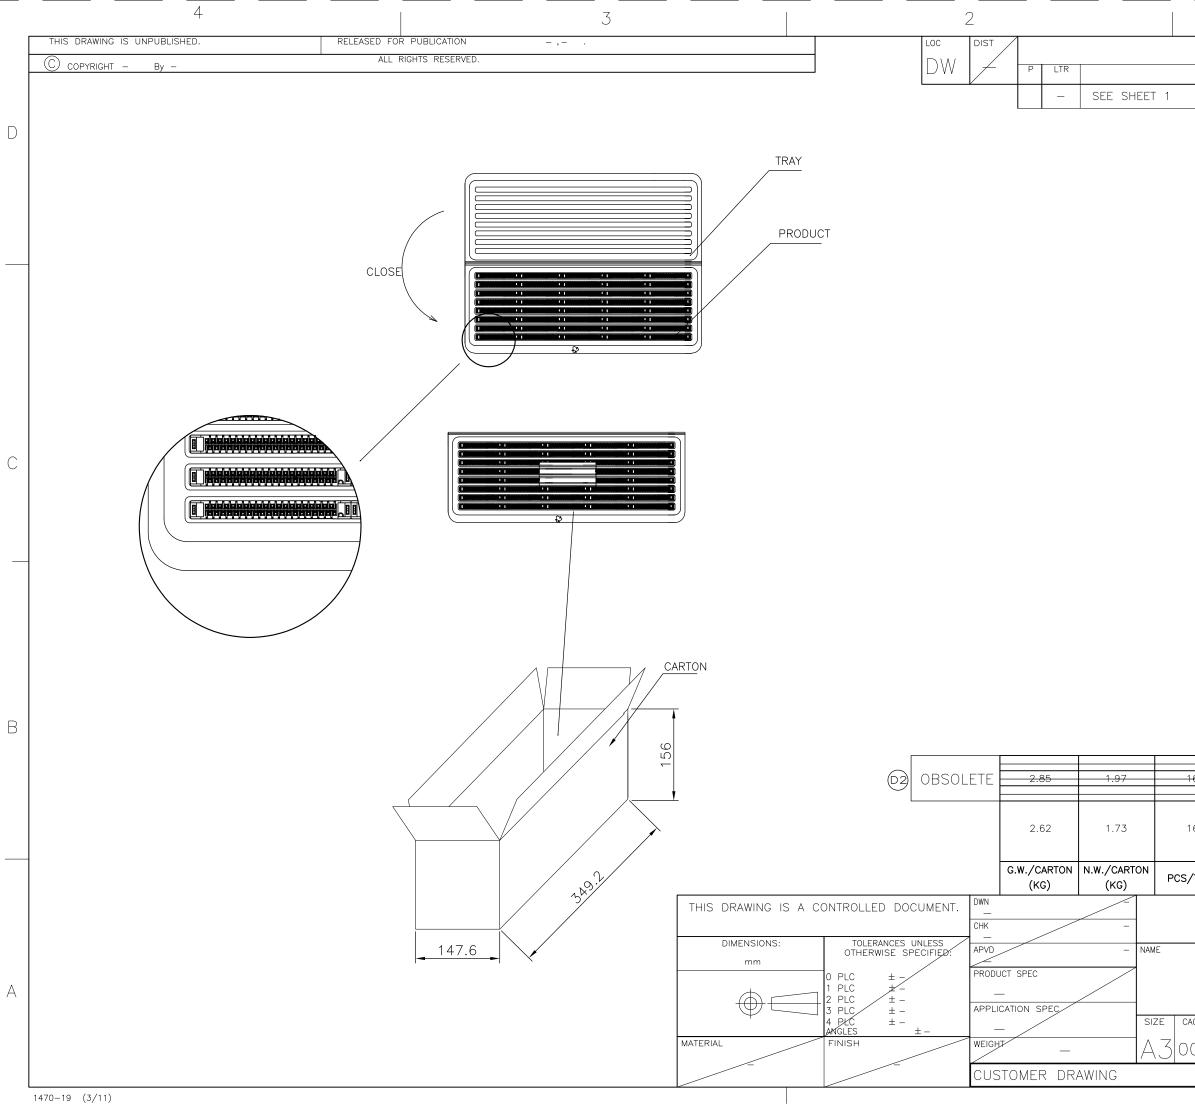

					В		
			5-1734100-8				
6	10	160	3-1734100-8	180			
			1-1734100-8				
6	10	160	5-1734100-6				
Ť			3-1734100-6	160			
			1-1734100-6				
/TRAY	TRAYS/CARTON	QUANTITY/CARTON (PCS)	PART NUMBER	POS.			
ETE TE Connectivity							
PLUG ASSEMBLY, VERTICAL BOARD-TO-BOARD, CHAMP .050, SERIES I							
GE CODE	DRAWING NO		RESTRICT	ED 70			
0779	<b>C–</b> 1734	100					
	SCAL	.E SHEET	4 OF 4 REV	Ε			

REVISIONS			
DESCRIPTION	DATE	DWN	APVD
	_	_	

D

С

## **Mouser Electronics**

Authorized Distributor

Click to View Pricing, Inventory, Delivery & Lifecycle Information:

TE Connectivity: <u>1-1734100-0</u>