


SCALA NON IMPEGNATIVA
(DO NOT SCALE)
DIMENSIONI IN
DIMENSIONS IN mm


METRIC

PROIEZIONE EUROPEA
(EUROPEAN PROJECTION)

Sezione B-B
(SECT. B-B)

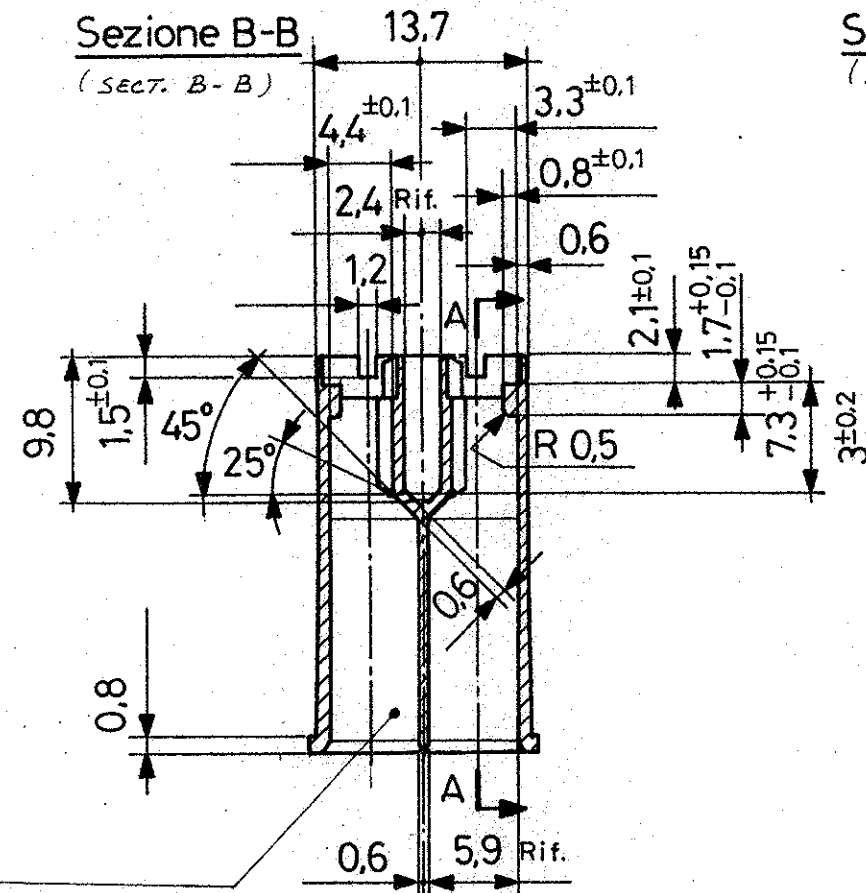


Sezione A-A
(SECT. A-A)

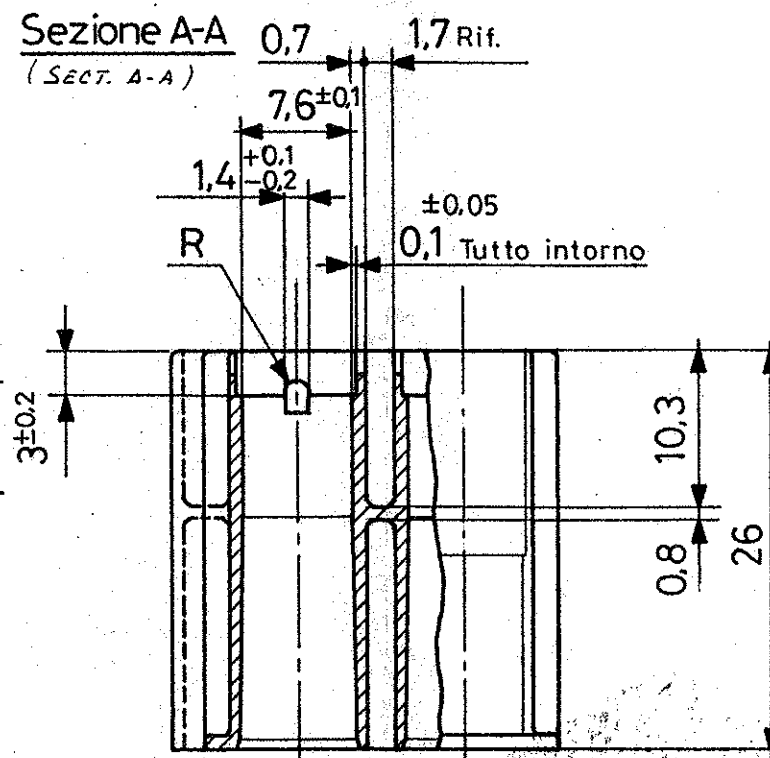

1 OBSOLETE PARTS: OBSOLETE CIS
STREAMLINING PER D.RENAUD/D.SINISI

QUATTRO CAVITÀ ADATTE PER
TERMINALI POSITIVE LOCK MK I,
ES. 160759-...

FOUR CAVITIES SUITABLE FOR POSITIVE
LOCK MK I REC. CONTACT,
E.G. P/N 160759-...

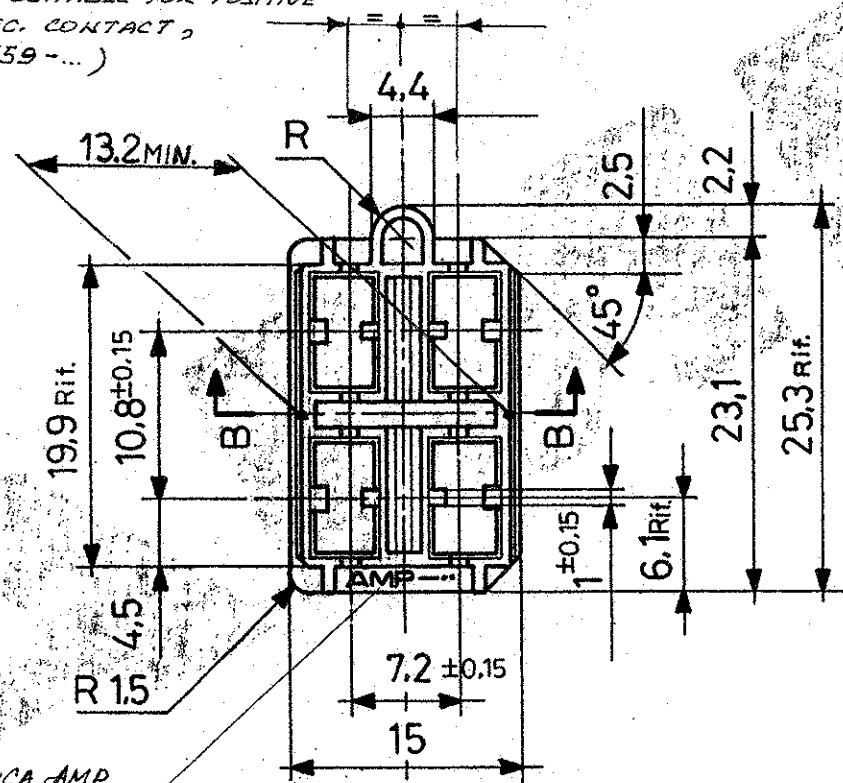

MARCHIO DI FABBRICA AMP
(AMP TRADE MARK)

OBSOLETE
OBSOLETE

~~Verde (GREEN)~~
~~Rosso (RED)~~
~~Nero (BLACK)~~
~~Naturale (CLEAR)~~

Poliammide 6.6
(PA 6.6 UNFILLED)

~~281889-4~~
~~281889-3~~
281889-2
281889-1

CUSTOMER DWG.
FOR REFERENCE ONLY

DISEGNO PER CLIENTE
SOLO PER RIFERIMENTO

THIS DRAWING IS UNPUBLISHED
© COPYRIGHT 1988 BY AMP INCORPORATED, HARRISBURG, PA ALL INTERNATIONAL RIGHT
RESERVED AMP PRODUCTS MAY BE COVERED BY U.S. AND FOREIGN PATENT AND/OR PATENT PENDING
TOLLERANZE: SE NON
DIVERSAMENTE SPECIFICATO
(TOLERANCES UNLESS OTHERWISE
SPECIFIED)
± 0.3
ANGOLI
(ANGLES) ± 2°
DIS.
(DR.)
Bassano 29-Feb. 88
DIAM. ISOLANTE
(INS. DIA. RANGE)
RANGO FILO
(WIRE RANGE)
SCALA
(SCALE)
2:1
AMP AMP ITALIA S.p.A.
Corso F.lli Cervi, 15
COLLEGNO (TORINO)

B1 REVISED PER ECO-09-026346 KK 27NOV 88
B REVISED OBSOLETE L. 4. A.B./C.7 09 JUL 91
A In Produzione 29.6 88
REV. (REV. LTR.) REVISIONI (REVISION RECORD) DIS. (DR.) DATA (DATE)
CONT. (CHK.)
APP. (APP.)
LOC. SIZE NUMERO (DWG NO.)
I A3 C-281889
REV. B1
FOGLIO (SHEET) 1 OF 1

Mouser Electronics

Authorized Distributor

Click to View Pricing, Inventory, Delivery & Lifecycle Information:

[TE Connectivity:](#)

[281889-1](#)